



BLK 405- 5TH STOREY PLAN SCALE 1:200

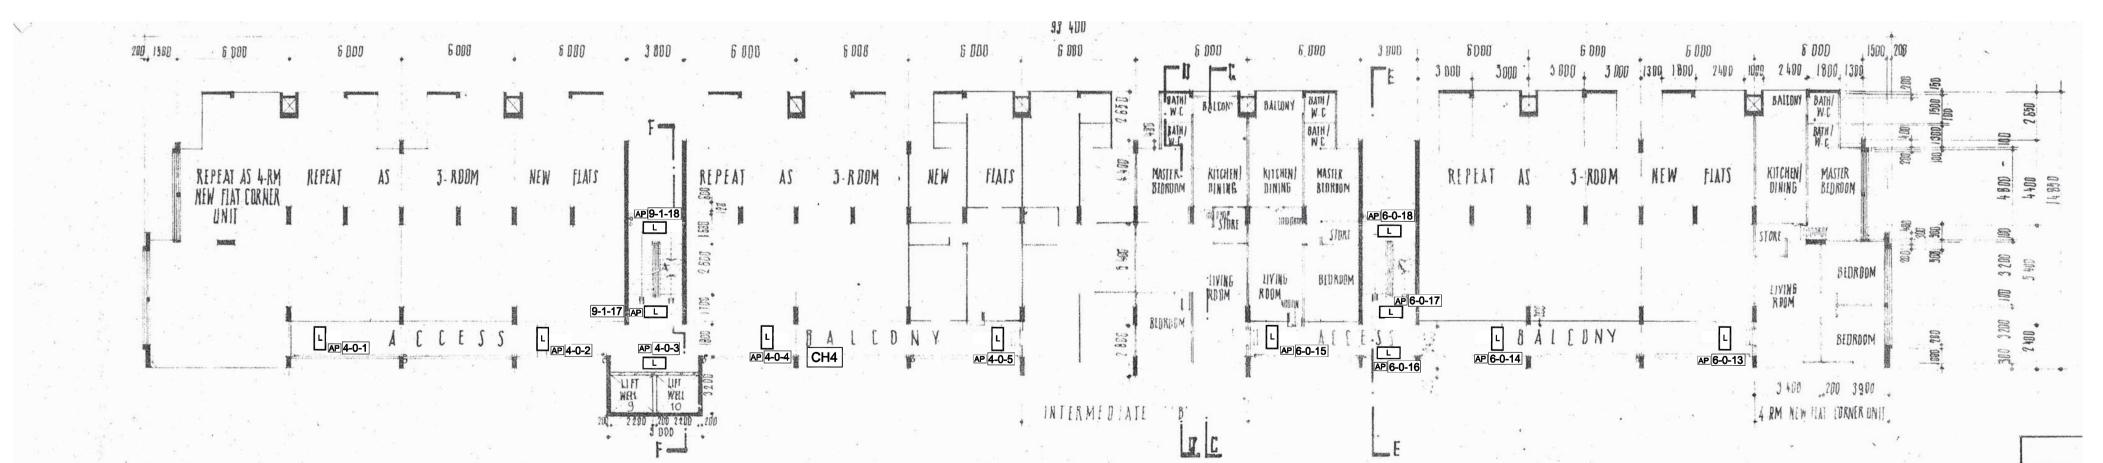

BLK 405- 4TH STOREY PLAN SCALE 1:200

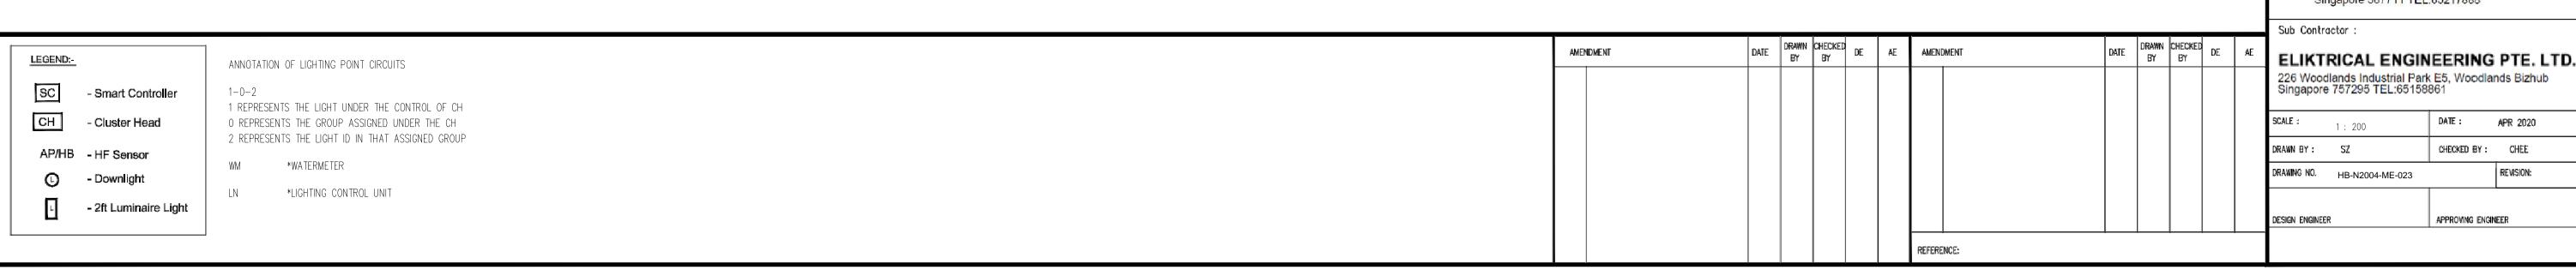

HOUSING & DEVELOPMENT BOARD HDB Hub 480 Lorong 6 Toa Payoh Singapore 310480

OWNER SIGNATURE: DRAWING NO. HB-N2004-ME-023 REVISION:

AS BUILT DRAWING

Bernard Lee
Vice-President
Sensors Business

PRECINT NAME: GREENPRINT @ TECK GHEE

Project Title

SUPPLY, INSTALL, TEST AND COMMISSION OF SMART LIGHTING SYSTEM AT ANG MO KIO AVENUE 10 (CONTRACT NO. BRI/018/18)

JOB Title :

ANG MO KIO NEIGHBOURHOOD 4 CONTRACT 1

Drawing Title :

BLK 405 PLAN - 4th, 5th & 6th STOREY PLAN (SMART LIGHTING LAYOUT)

Main Contractor:

ST Engineering

Electronics 6 Ang Mo Kio Electronics Park Road Singapore 567711 TEL:65217888