AS BUILT DRAWING

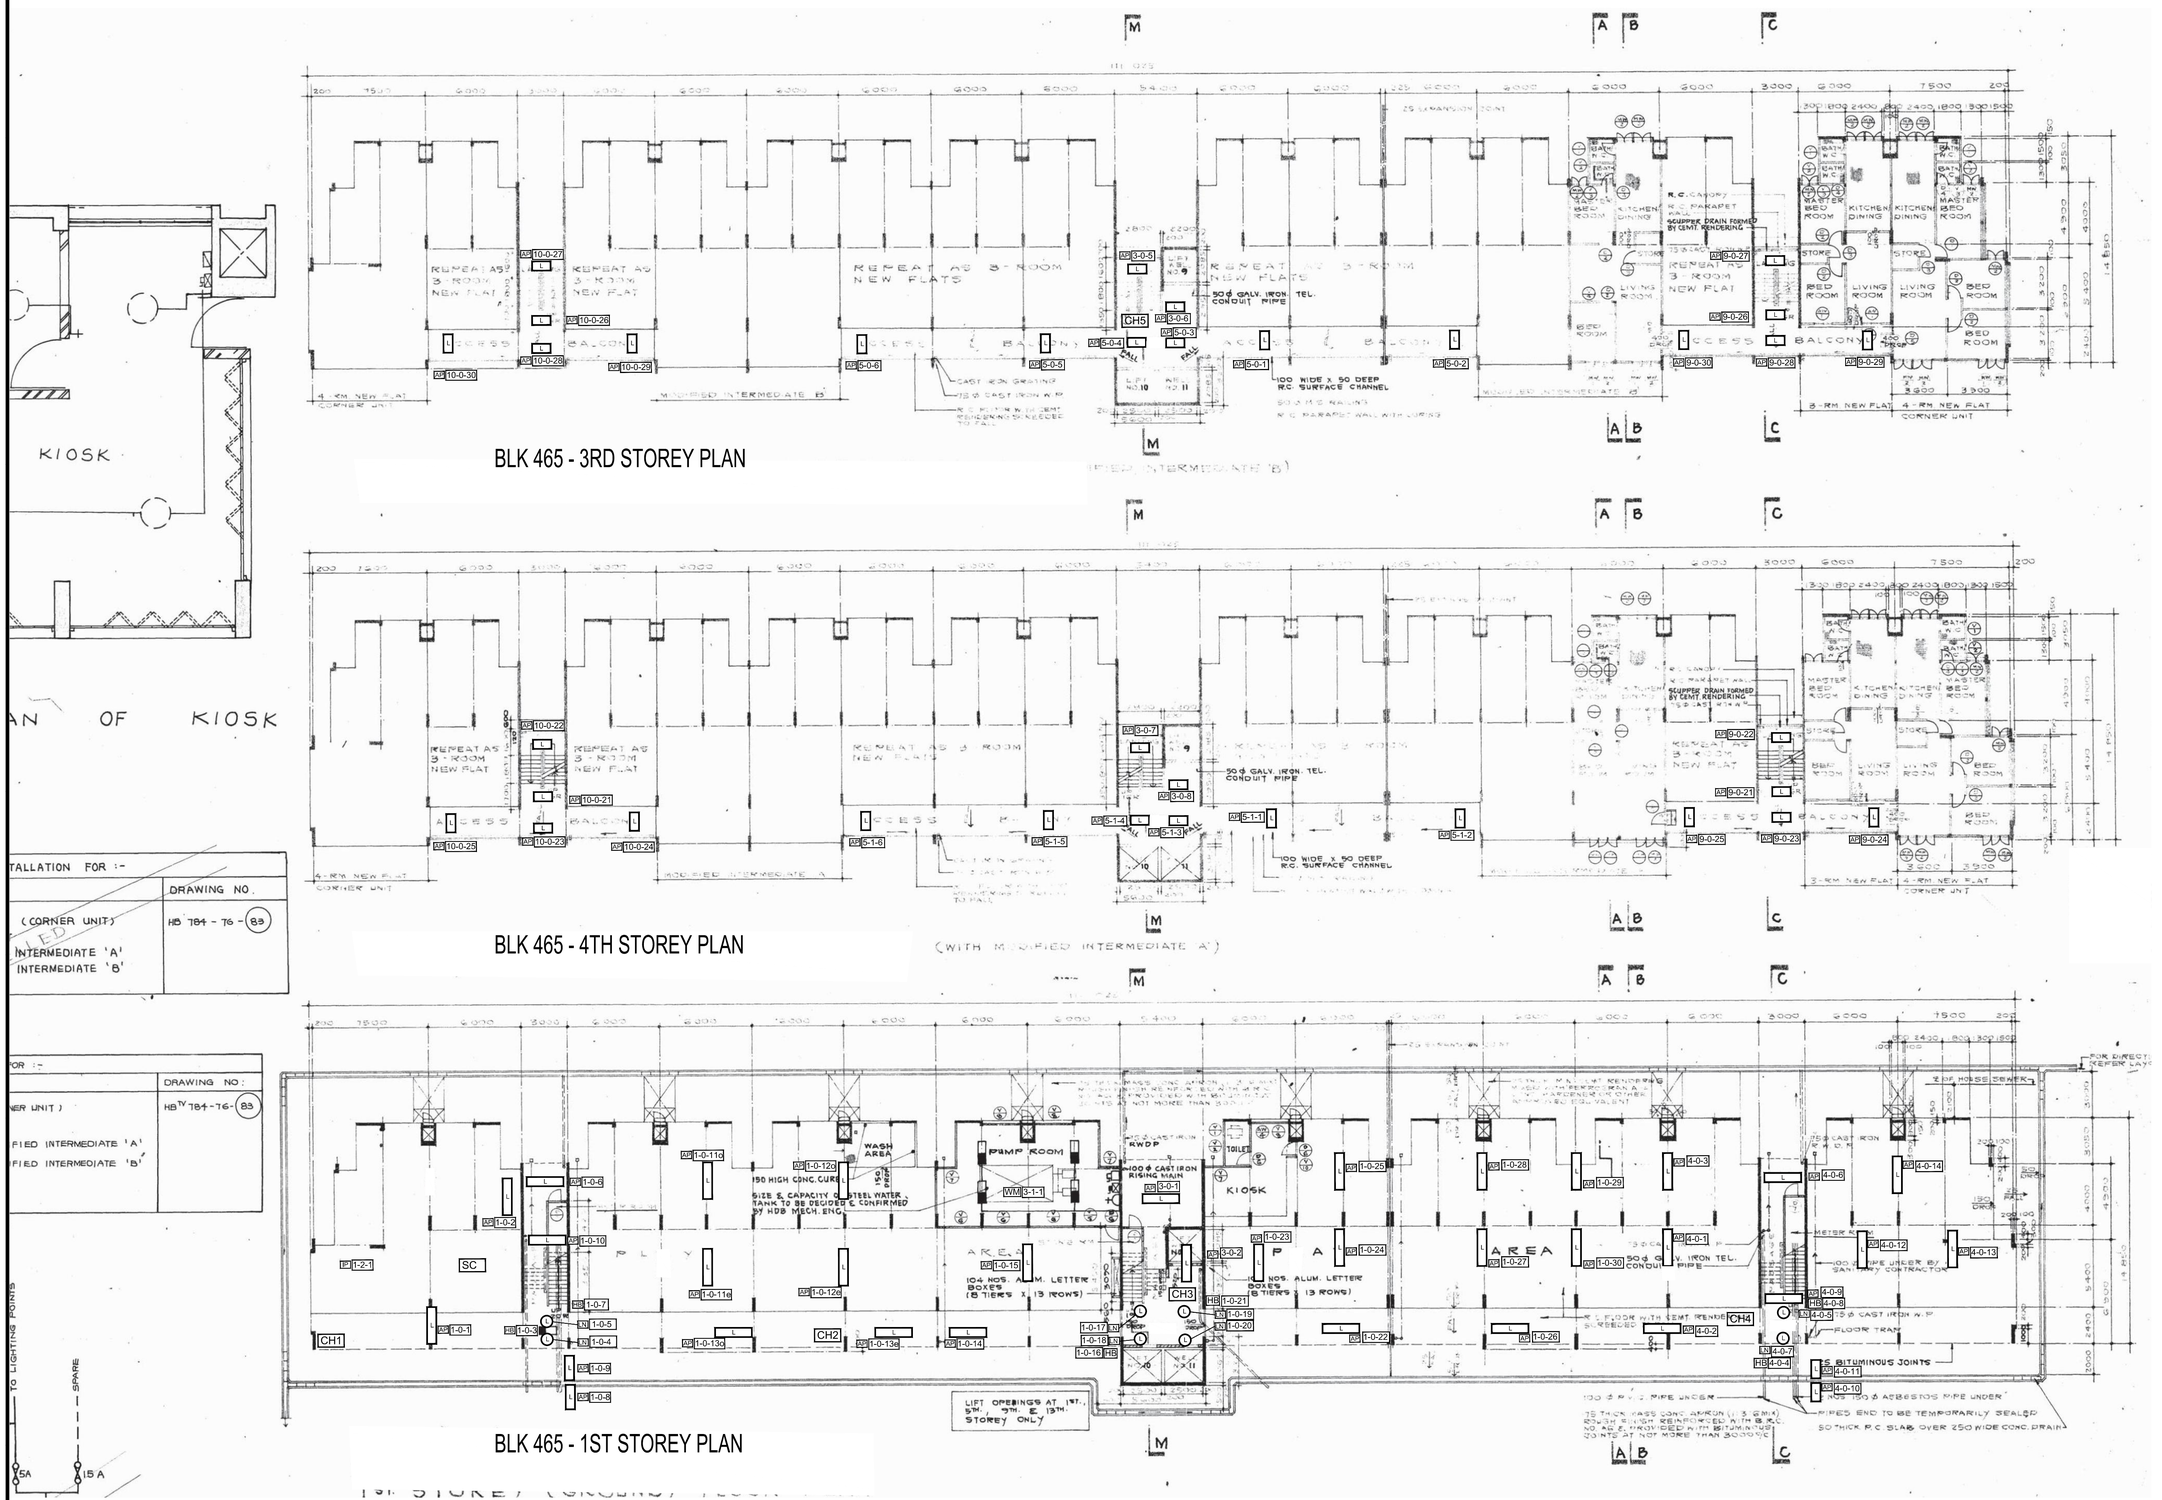

LEGEND:-	
SC	- Smart Controller
CH	- Cluster Head
AP/HB	- HF Sensor
⊙	- Downlight
L	- 2ft Luminaire Light

ANNOTATION OF LIGHTING POINT CIRCUITS

1-0-2
1 REPRESENTS THE LIGHT UNDER THE CONTROL OF CH
0 REPRESENTS THE GROUP ASSIGNED UNDER THE CH
2 REPRESENTS THE LIGHT ID IN THAT ASSIGNED GROUP

WM *WATERMETER

LN *LIGHTING CONTROL UNIT

AMENDMENT	DATE	DRAWN BY	CHECKED BY	DE	AE

AMENDMENT	DATE	DRAWN BY	CHECKED BY	DE	AE

REFERENCE:

HOUSING & DEVELOPMENT BOARD
HDB Hub 480 Lorong 6 Toa Payoh
Singapore 310480

OWNER SIGNATURE:

DRAWING NO.	HB-N2004-ME-349	REVISION:
PRECINT NAME:	GREENPRINT @ TECK GHEE	

Project Title :

SUPPLY, INSTALL, TEST AND COMMISSION OF SMART LIGHTING SYSTEM AT ANG MO KIO AVENUE 10 (CONTRACT NO. BRI/018/18)

JOB Title :

ANG MO KIO NEIGHBOURHOOD 4 CONTRACT 15

Drawing Title :

BLK 465 - 1st, 3rd & 4th Storey Plan
(Smart Lighting Layout)

Main Contractor :

ST Engineering Electronics
6 Ang Mo Kio Electronics Park Road
Singapore 567711 TEL:65217888

Sub Contractor :

ELIKTRICAL ENGINEERING PTE. LTD.
226 Woodlands Industrial Park E5, Woodlands Bizhub
Singapore 757295 TEL:65158861

SCALE : 1 : 200	DATE : APR 2020
DRAWN BY : SZ	CHECKED BY : CHEE
DRAWING NO. HB-N2004-ME-349	REVISION:
DESIGN ENGINEER	APPROVING ENGINEER